

DESIGN · BUILD

Builders/contractors shall verify all dimensions on site before any work commences. Figure dimensions precede scaled. Any discrepancies shall be made known prior to any works commencing.

COPYRIGHT: © Kerr Design Build
This work is covered by copyright & cannot be reproduced or copied in any form or by any means without written

permission of Kerr Design Build


Hycroft 1489 McRae Ave, Vancouver REV DATE DETAILS INIT

AS-BUILT LOWER LEVEL

3/16" = 1'-0"@24"x36" AB-0 rev.


Drawn Design Checked project no.

XJ NM Checker

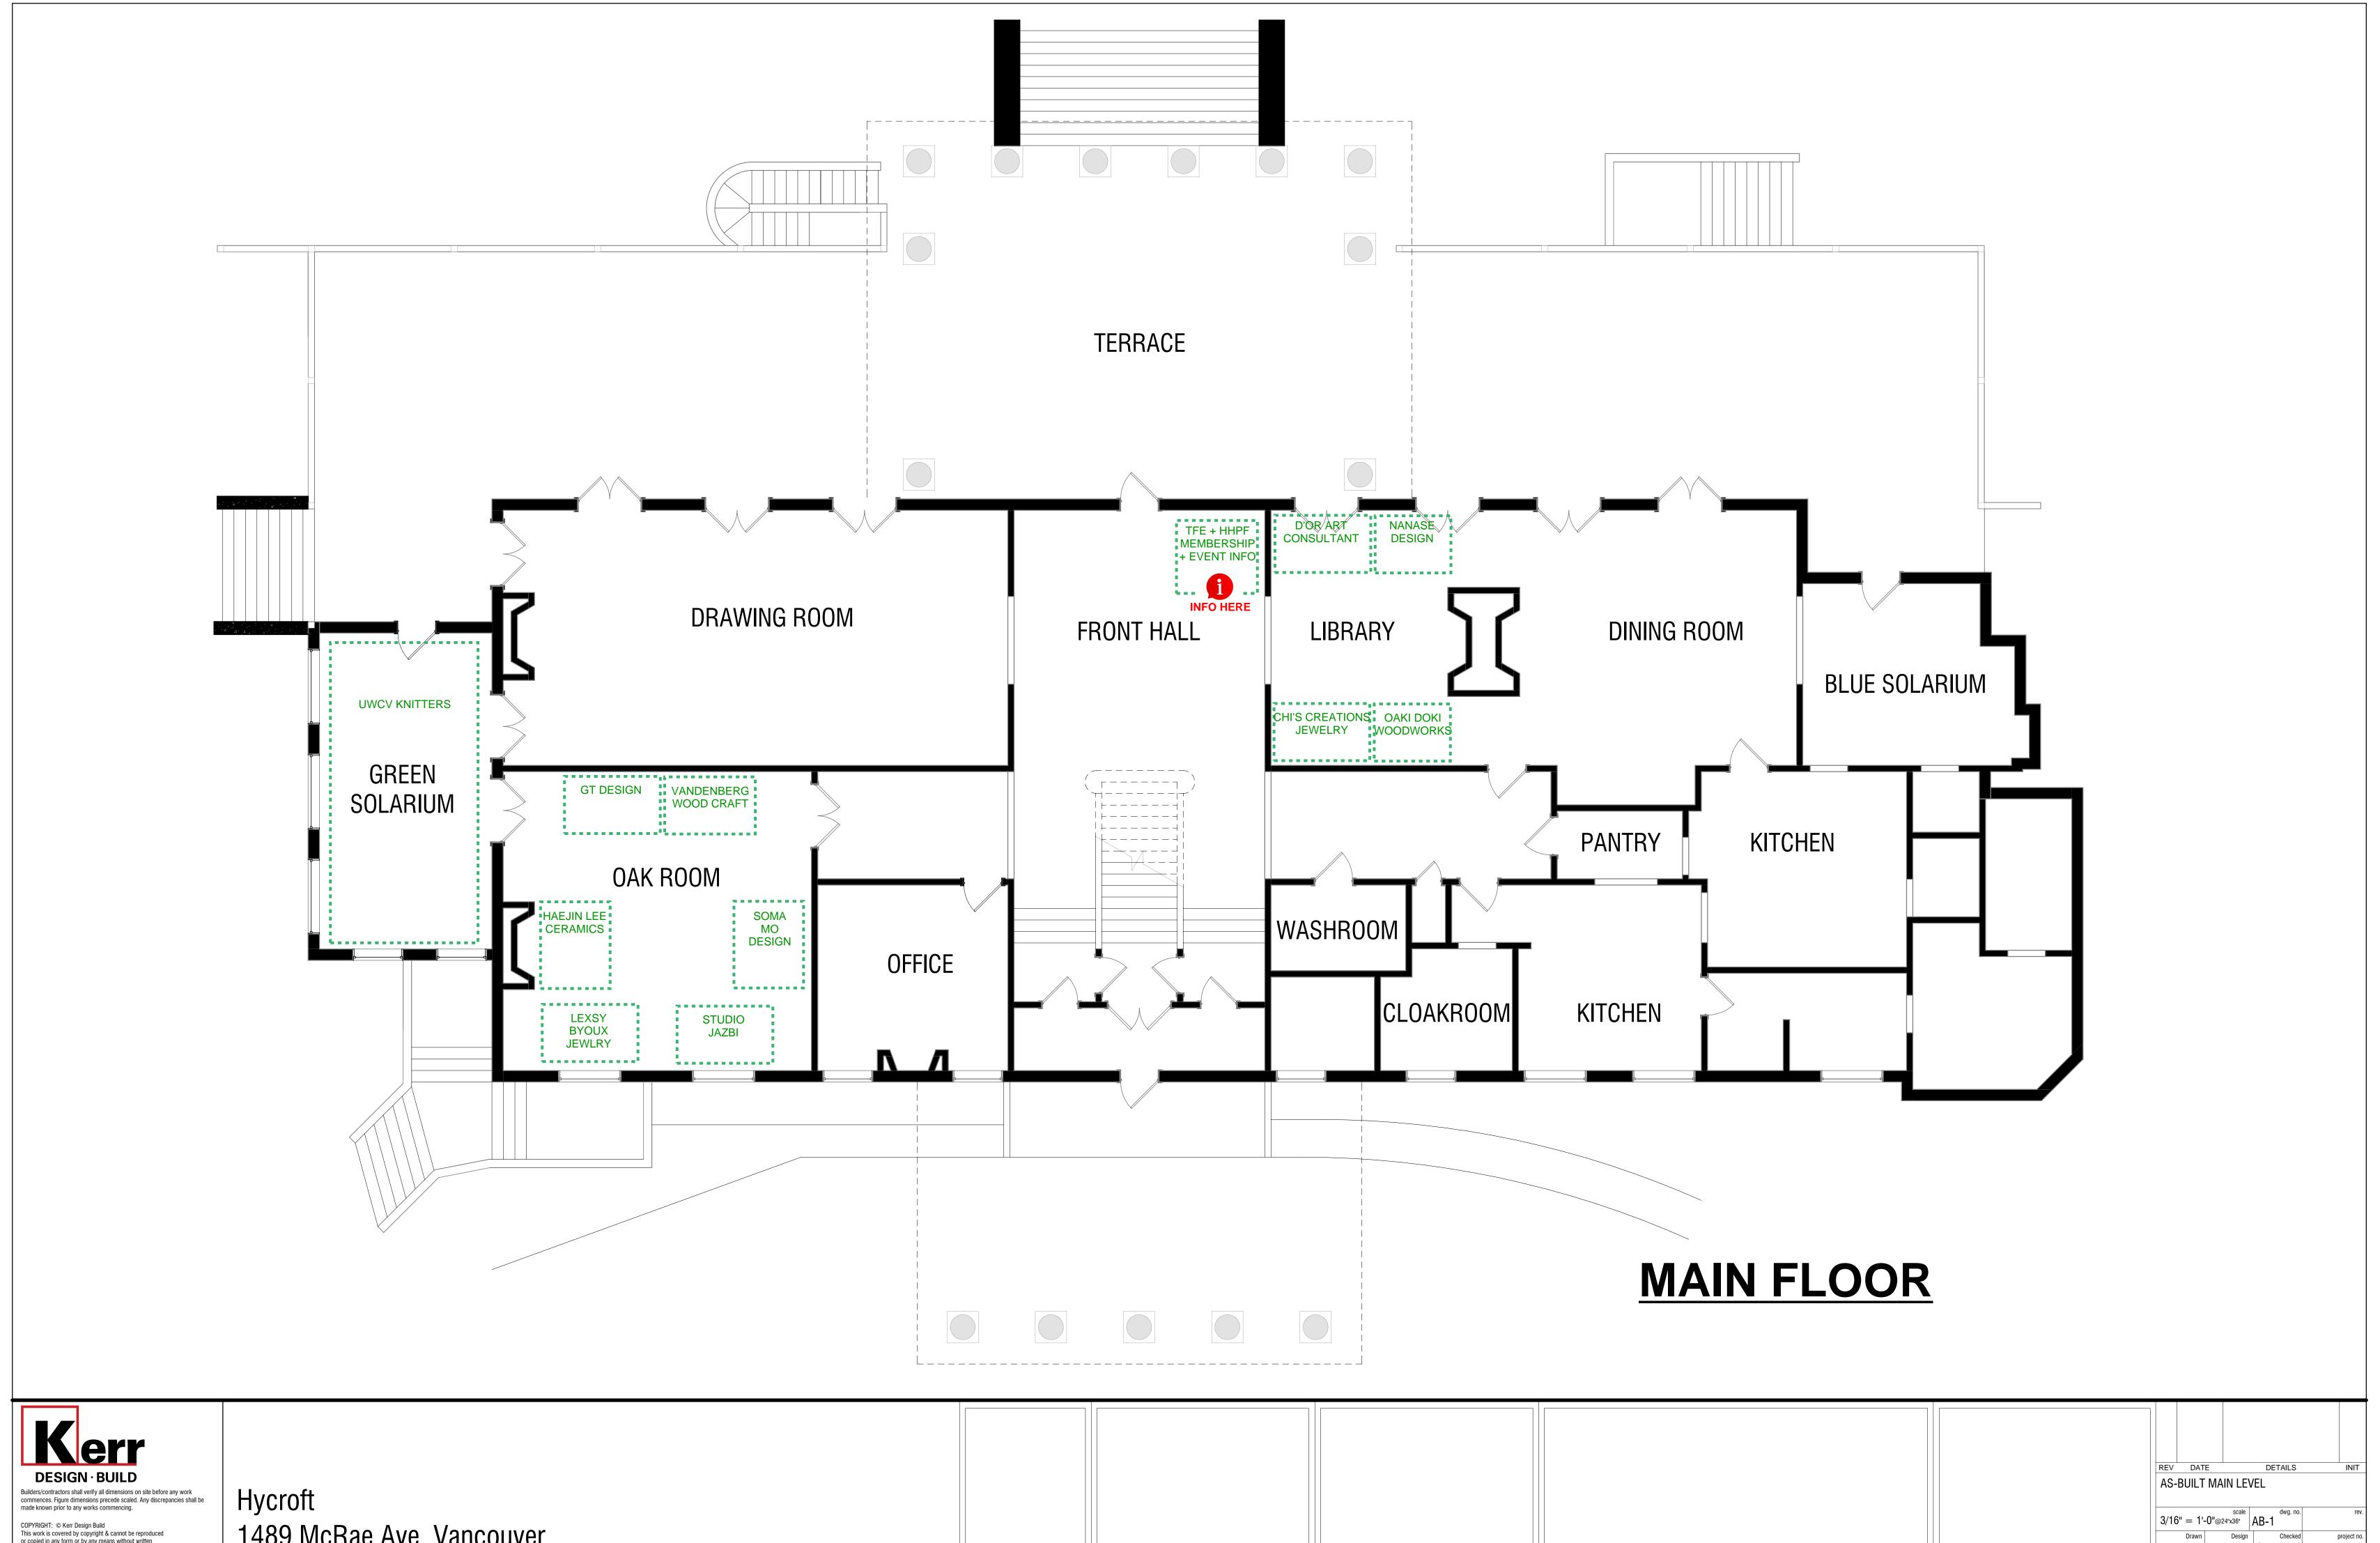

COPYRIGHT: © Kerr Design Build
This work is covered by copyright & cannot be reproduced
or copied in any form or by any means without written
permission of Kerr Design Build

1489 McRae Ave, Vancouver

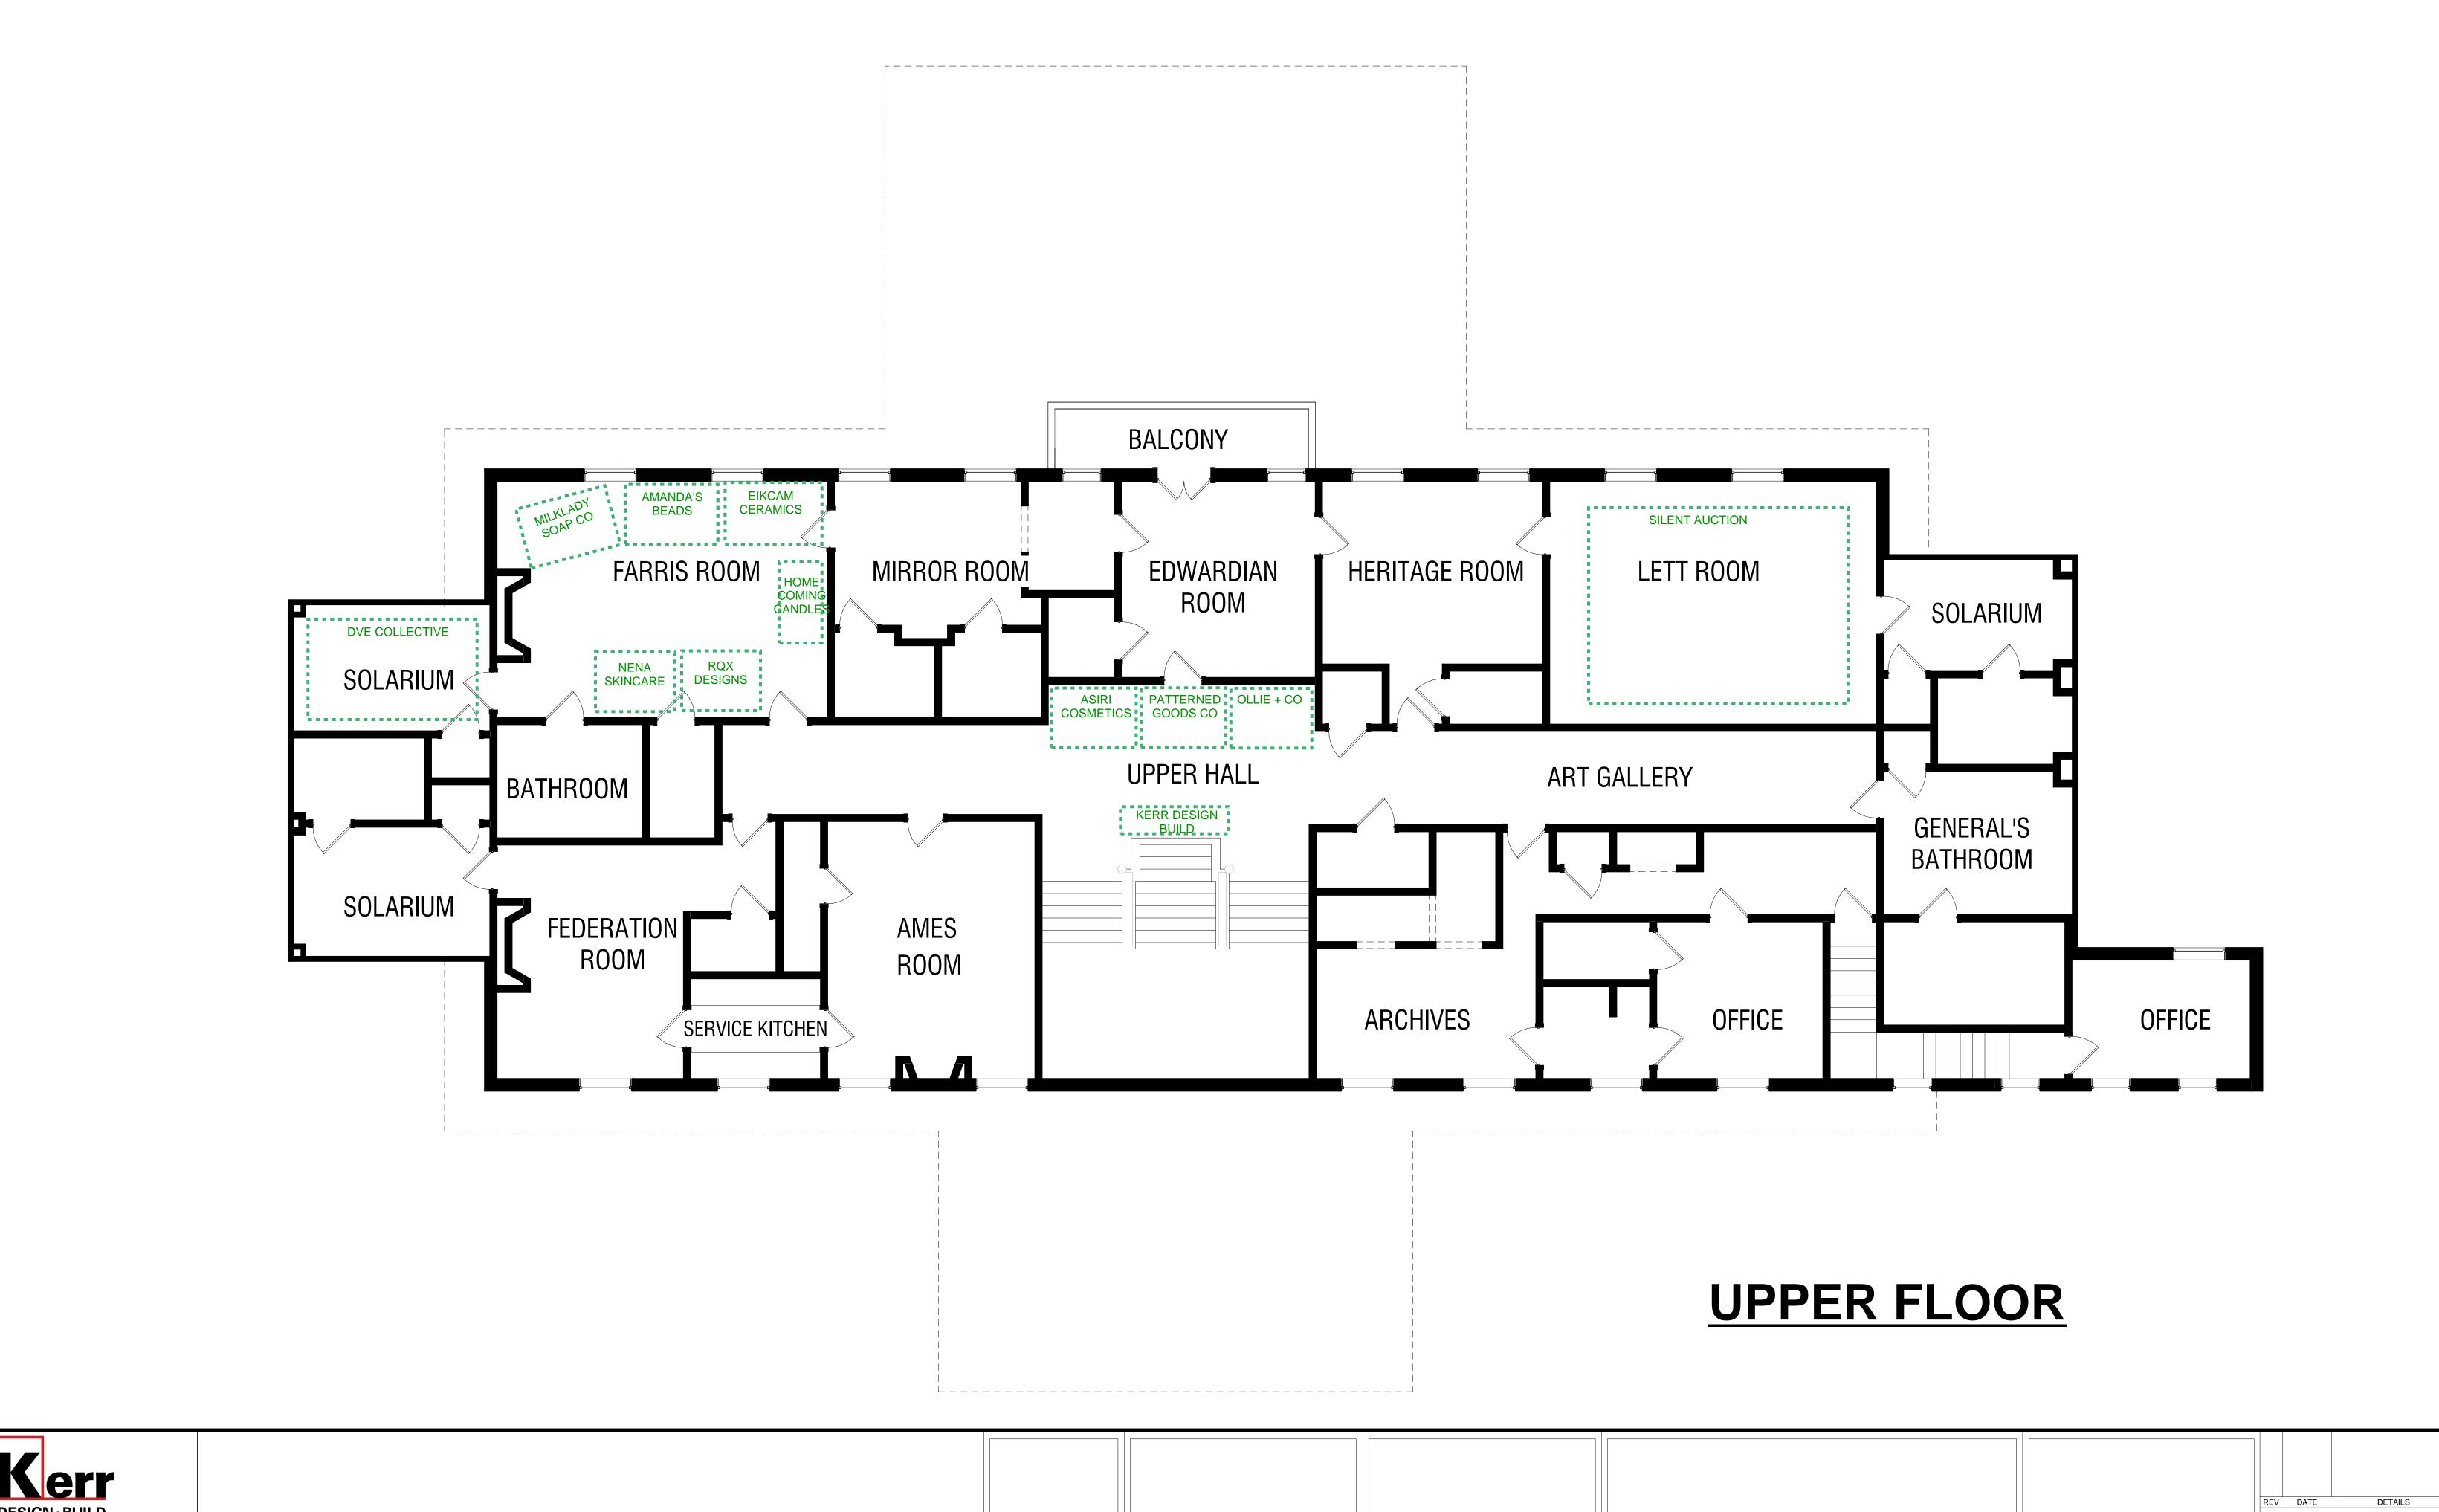

DESIGN - BUILD

Builders/contractors shall verify all dimensions on site before any work commences. Figure dimensions precede scaled. Any discrepancies shall be made known prior to any works commencing.

COPYRIGHT: © Kerr Design Build
This work is covered by copyright & cannot be reproduced or copied in any form or by any means without written

permission of Kerr Design Build

Hycroft 1489 McRae Ave, Vancouver REV DATE DETAILS INI

AS-BUILT UPPER LEVEL

3/16" = 1'-0"@24"x36" AB-2

Drawn Design Checked project

XJ NM Checker